

Sketch in left
for not shown and
Baker May 13, 1915.

W. S. KING, CIVIL ENGINEER
REGISTERED SURVEYOR AND STATE LICENSED SURVEYOR
ROOM 312, 1015 J STREET, SAN DIEGO, CALIFORNIA
SAN DIEGO, CALIFORNIA


PLAT

of Curlew St. from N. line of Plam
to N. line of Redwood Sts.

Grade elevations shown in red.

Scale 1" = 100'

W. S. King.

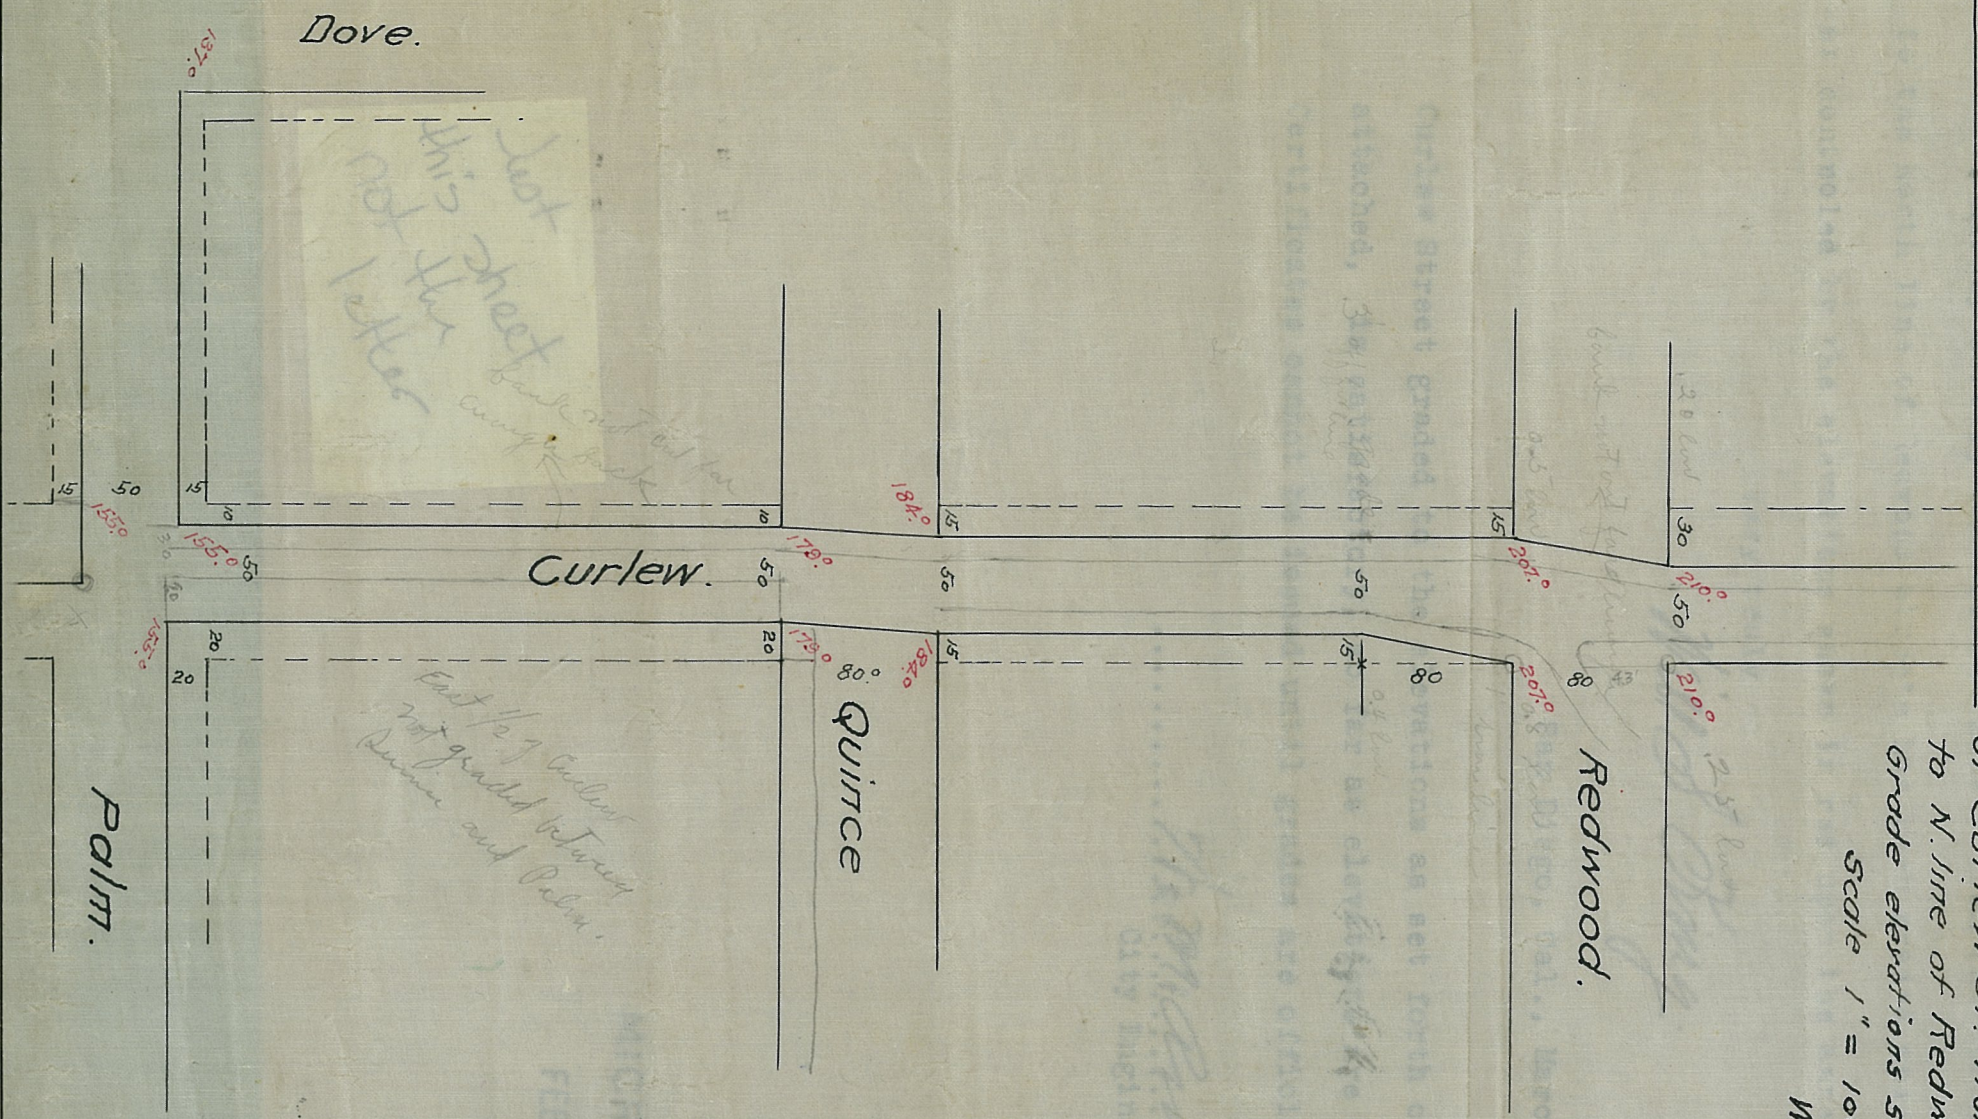

DRAWN BY W. S. King
CHECKED BY _____
FIELD BOOKS _____
CITY ENGINEER _____
MGR. OF OPERATION _____

CITY OF SAN DIEGO-OPERATING DEPARTMENT
CURLEW STREET
from North line of Palm St. to North line of Redwood St.

DATE March 1915.
SCALE 1" = 100'
DRAWING NUMBER
276 B

MICROFILMED
FEB - - 1969

Indexed