

PARCEL 2
PM 18971

MATCHLINE
SEE SHEET 5


5' WIDE G.U.E.
PARCEL '10'

CARMEL VALLEY RD.
STREET DEDICATION
PARCEL 'A'
AREA: 11.874 AC.

5' WIDE G.U.E.
PARCEL '2'

APN: 305-031-12

PARCEL 3
PM 18971

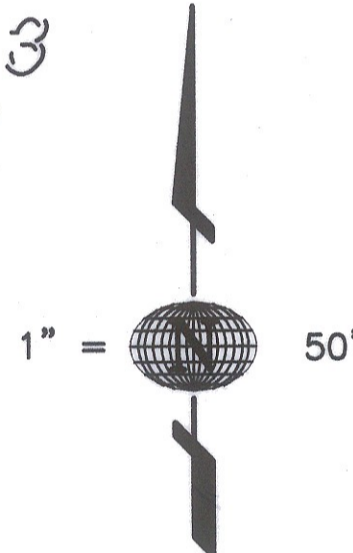

R=1904.00'
D=29°28'44"
L=979.61'

N16°41'08"E
194.78'

CARMEL VALLEY ROAD

N16°41'08"E
239.22'

MATCHLINE
SEE SHEET 3

Latitude 33



Planning and Engineering
4933 Paramount Drive, 2nd Floor
San Diego, CA 92123
858-751-0633 Fax 858-751-0634

H:\400\482.10\MAPS\PLATS\CVR-PL04.dwg 7/8/2003 5:43:25 PM PST

RECORDING DATA ON SHEET 1

C. John Eardensohn

7-14-03

C. JOHN EARDENSOHN L.S. 5278 DATE
REGISTRATION EXPIRES 12-31-03

STREET DEDICATION - CARMEL VALLEY ROAD
GENERAL UTILITY EASEMENT
NORTH OF STATE ROUTE 56

DESCRIPTION	BY	APPROVED	DATE	FILMED
ORIGINAL	LAT33			MAR 9 '03
	RVH			MAR 9 '04

CITY OF SAN DIEGO, CALIFORNIA
DEVELOPMENT SERVICES DEPARTMENT
SHEET 4 OF 12 SHEETS

W.O. NO. 991086

Lee Hennessy
FOR CITY ENGINEER

9-16-03
DATE

1930-6271
CCS '83 COORDINATES

290-1711
LAMBERT COORDINATES

AS BUILT

00031-4-C