


DATA TABLE

NO.	BRNG/DELTA	RADIUS	LENGTH
C1	N45°31'28"W	---	28.17'
C2	N23°13'44"W	---	111.68'
C3	N29°03'45"E	---	11.79'
C4	N21°19'08"W	---	81.80'
C5	N23°05'05"E	---	15.51'
C6	N22°19'37"W	---	42.75'
C7	N28°45'31"W	---	34.70'
C8	N52°55'48"E	---	17.60'
C9	N23°17'50"W	---	82.95'
C10	N33°39'10"E	---	25.30'
C11	N24°20'22"W	---	59.93'
C12	N26°18'39"W	---	38.37'
C13	N49°09'23"E	---	16.88'
C14	N25°32'17"W	---	86.86'
C15	N06°46'25"E	---	17.27'
C16	N36°34'00"W	---	90.18'
C17	N51°17'39"W	---	55.00'
C18	N56°50'35"W	---	50.21'
C19	N79°11'18"W	---	35.32'
C20	N85°11'55"W	---	62.63'
C21	S74°27'34"W	---	90.28'
C22	N72°12'20"W	---	24.79'
C23	N70°45'18"W	---	42.12'
C24	N33°05'06"W	---	220.84'
C25	N56°38'19"W	---	37.46'
C26	S83°48'27"W	---	173.31'
C27	S84°54'52"W	---	159.30'
C28	N67°10'13"W	---	41.57'
C29	S45°02'32"W	---	89.65'
C30	S45°22'38"E	---	68.13'
C31	S33°02'09"W	---	97.90'
C32	S00°14'39"E	---	156.68'
C33	S24°30'25"W	---	56.23'
C34	S21°51'03"W	---	31.21'
C35	S53°34'15"W	---	80.85'
C36	S39°02'26"W	---	42.16'
C37	S23°01'20"W	---	70.31'
C38	S13°15'00"W	---	19.72'
C39	S49°47'06"W	---	57.71'
C40	S35°41'49"W	---	27.11'
C41	S21°38'45"W	---	35.23'
C42	S09°41'45"W	---	46.96'
C43	S16°34'08"E	---	21.79'
C44	S61°37'24"E	---	131.06'
C45	S82°38'15"E	---	66.08'
C46	N75°26'11"E	---	29.19'
C47	S41°53'28"E	---	102.38'
C48	S55°11'45"E	---	47.47'
C49	S73°03'03"E	---	78.86'
C50	S05°32'21"E	---	93.24'


DATA TABLE

NO.	BRNG/DELTA	RADIUS	LENGTH
C51	S17°04'09"E	---	51.97'
C52	S54°15'59"E	---	17.40'
C53	S08°58'41"W	---	101.79'
C54	S40°04'42"W	---	46.40'
C55	S25°52'01"W	---	46.75'
C56	S01°20'47"W	---	82.50'
C57	S84°24'17"W	---	32.92'
C58	N19°27'17"W	---	57.86'
C59	N52°24'32"W	---	98.91'
C60	N66°57'33"W	---	124.68'
C61	S81°17'32"W	---	89.03'
C62	S49°23'20"W	---	156.00'
C63	N64°34'20"W	---	297.13'
C64	N31°10'42"W	---	28.37'
C65	N03°46'01"W	---	23.69'
C66	N10°39'06"E	---	89.94'
C67	S71°48'27"E	---	42.86'
C68	N67°35'08"E	---	16.66'
C69	N14°08'42"E	---	25.59'
C70	N03°59'45"E	---	27.67'
C71	N16°06'33"W	---	49.38'
C72	N44°42'54"W	---	40.49'
C73	N13°49'59"W	---	52.94'
C74	N79°20'16"W	---	45.07'
C75	S36°28'00"W	---	27.18'
C76	N85°37'06"W	---	75.94'
C77	S59°22'36"W	---	58.19'
C78	S04°54'10"E	---	183.53'
C79	S37°36'18"W	---	39.63'
C80	S87°52'51"W	---	170.71'
C81	N42°07'03"W	---	13.02'
C82	S80°18'56"W	---	15.52'
C83	N02°13'55"W	---	37.59'
C84	N54°18'03"W	---	15.77'
C85	N04°10'12"W	---	63.35'
C86	N50°43'54"W	---	19.75'
C87	N05°45'14"W	---	73.06'
C88	N33°31'01"W	---	41.11'
C89	N09°47'40"W	---	78.74'
C90	N68°09'48"W	---	78.39'
C91	N25°21'46"W	---	52.52'
C92	N12°53'51"W	---	52.49'
C93	N18°49'16"W	---	77.16'
C94	N26°06'45"W	---	47.32'
C95	N82°11'26"W	---	22.34'
C96	S61°32'09"W	---	92.79'
C97	N80°22'10"W	---	23.33'
C98	S84°48'34"W	---	28.76'
C99	N58°52'30"W	---	74.44'
C100	N38°36'43"W	---	60.34'


SEE SHEET 1

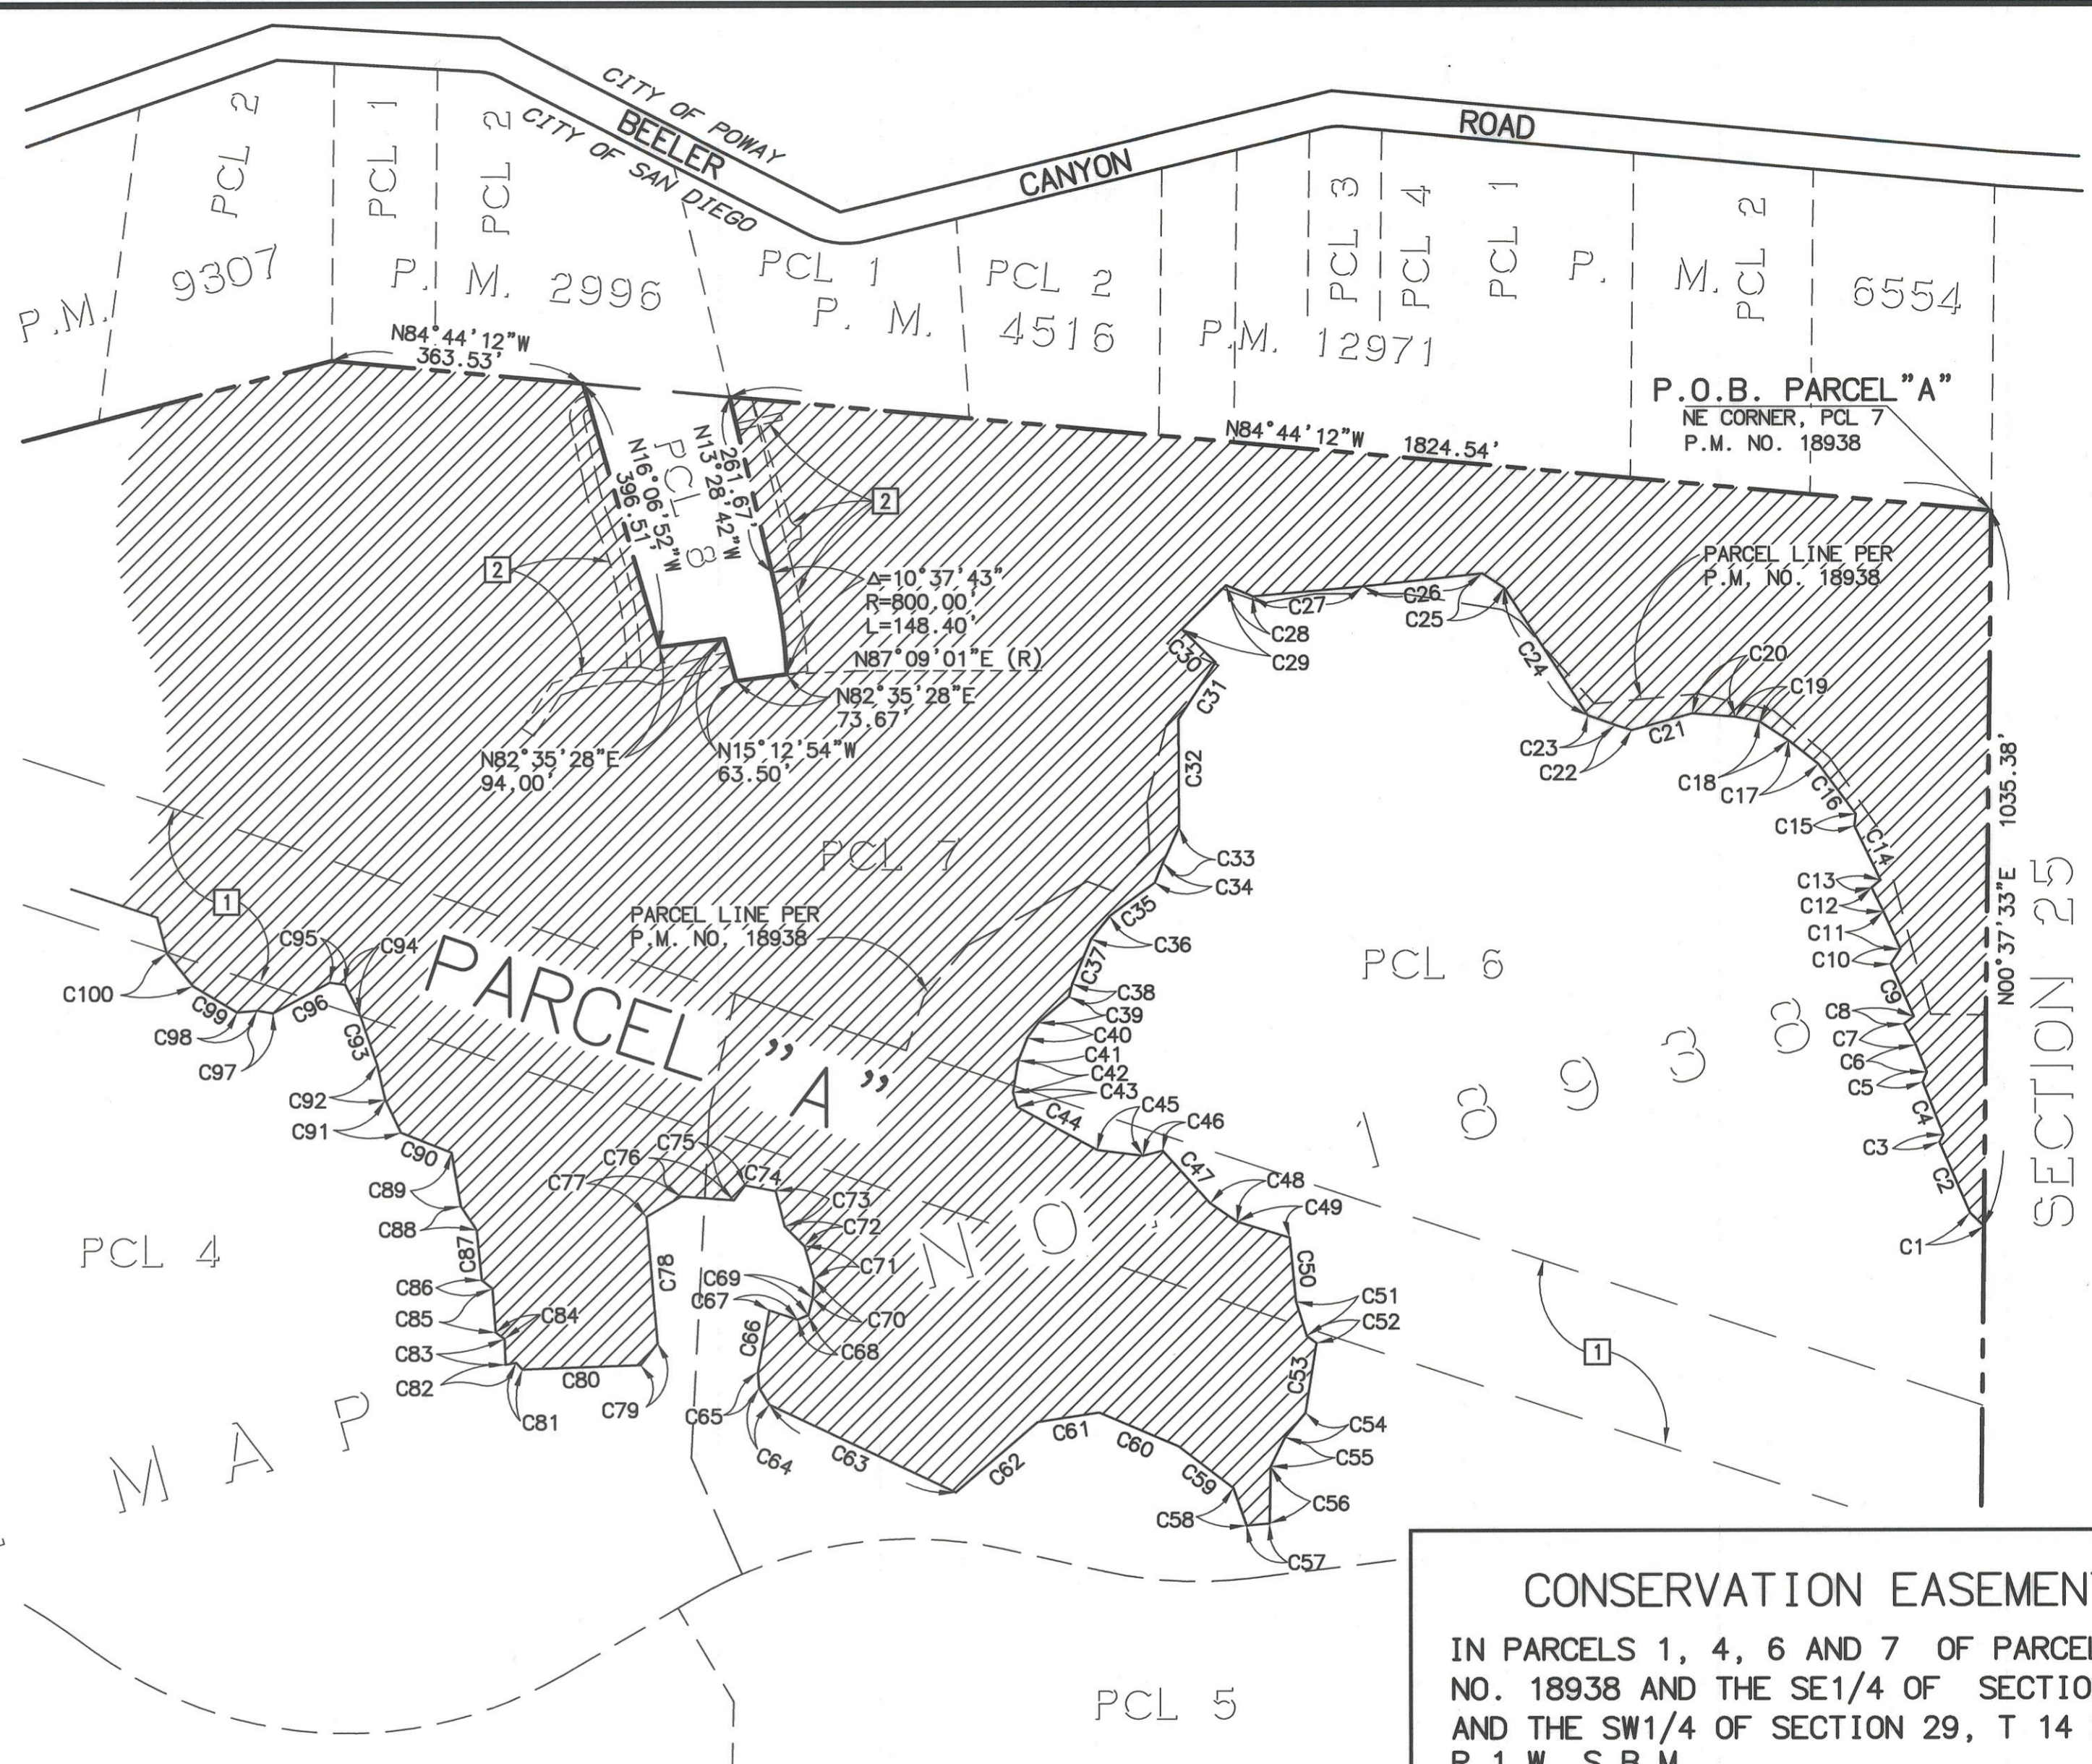

PARCEL MAP

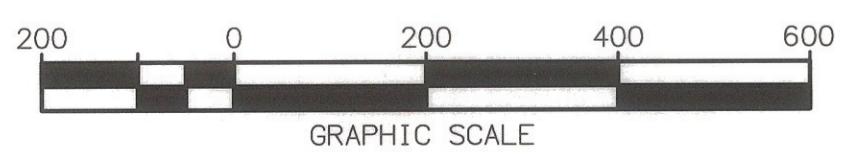

CONSERVATION EASEMENT				
IN PARCELS 1, 4, 6 AND 7 OF PARCEL MAP NO. 18938 AND THE SE1/4 OF SECTION 30 AND THE SW1/4 OF SECTION 29, T 14 S, R 1 W, S.B.M.				
CITY OF SAN DIEGO, CALIFORNIA DEVELOPMENT SERVICES DEPARTMENT SHEET 2 OF 3 SHEET			T.M. 99-0295 W.O. 420157	
<i>Richard</i> FOR CITY ENGINEER		10/28/02 DATE		
DESCRIPTION	BY	APPROVED	DATE	FILMED
ORIGINAL	RBF			NOV 21 02
<i>SGE SHT 1</i>				NOV 21 02
AS BUILT				NOV 21 02
CONTRACTOR		DATE STARTED		
INSPECTOR		DATE COMPLETED		
				1916-6311 NAD 83 COORDINATES
				276-1751 LAMBERT COORDINATES
				000862-C

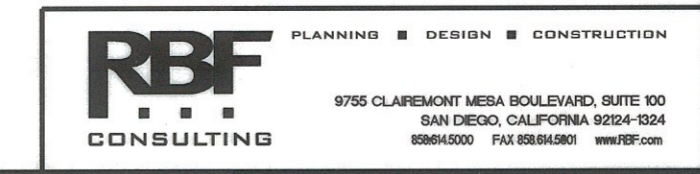

T 14 S SECTION 25 R 2 W S. B. M.